


PREPARED BY  
HIGHWAY PLANNING SURVEY  
IN COOPERATION WITH  
U.S. PUBLIC ROADS ADMINISTRATION


STATE OF MINNESOTA  
DEPARTMENT OF HIGHWAYS  
ROAD LIFE STUDIES  
CONSTRUCTION PROJECT LOG RECORD

CONTROL SECTION 6947  
TRUNK HIGHWAY 37  
COUNTY St. Louis  
DISTRICT 16

LIMITS: W. Jct. T.H. 169 (Jct. T.H. 73) at W. Limits of Hibbing - Jct. T.H. 53  
(E. end Br.)  
(See sheet 2 for data subsequent to 1975)

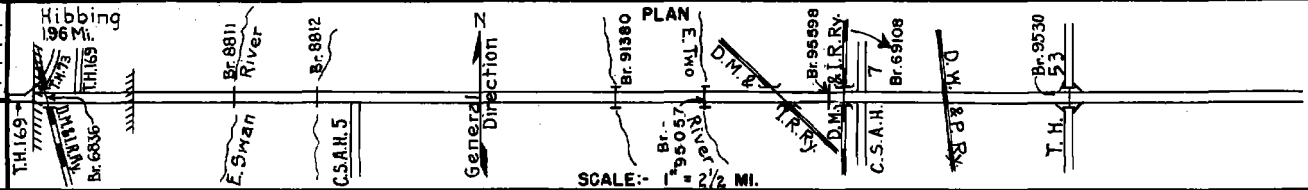

| YEAR BUILT | PROJECT N° | DESCRIPTION                                |                       | CODE N°                                    |
|------------|------------|--|-----------------------|--|
|            |            | TYPE                                       | WIDTH THICKNESS       |  |
|            |            | P.C. Concrete<br>6 Bridges (1)             | 20'                   | No Record of Const. Added in 1949          |
| 1940       | 6934-08    | Widening<br>P.C. Concrete                  | 10'                   | 9-6-9                                      |
| C          |            | Bit. Resurfacing                           |                       | On old concrete                            |
| 1950       | A.F.E. 17  | Mixed Bit.                                 | 21' 1 1/2"            | RT-6, 71987 Gal.<br>Agg. 4588 Tons         |
| C          |            | Base (3)                                   |                       | Const. C128D (Br. 8811)                    |
| 1953       | 6947-02    | Plant Mix Bit.<br>Grav. Shoulders          | 22' 3'-4"<br>10'      | C1010D (Br. 8812)<br>5' Rt. & Lt.          |
| C          |            | Install C.M. Culv.                         |                       |  |
| 1954       | A.F.E. 824 |  |                       |  |
| C          |            |  |                       | Top Widened to 40'                         |
| 1955       | 6947-06    | Shoulder Grading                           |                       |  |
| C          | 6947-03    | Grading                                    | 44'                   | 1.25 Mi. Divided Highway                   |
| 1956       | 6947-04    | Grav. Base & Sub-base<br>Mixed Bit. (Base) | 15'<br>26 1/2" 1 1/2" | (Const. temp. U.P. to be replaced in 1957) |
| C          |            | Br. 6836                                   |                       | 178' B.S. - U.P.                           |
| 1957       | 6947-05    |  |                       |  |
| (4)        |            |  |                       |  |
| C          |            | Concrete                                   | 48' 8"                |  |
| 1958       | 6947-08    |  |                       |  |
| C          |            | Plant Mix Bit.                             | 24 1/2" 4"            |  |
| 1958       | 6947-09    |  |                       |  |
| C          | 6917-37    | Br. 9530                                   | 30'                   | 214' C.G.S. - O.H.                         |
| 1959       | 6947-10    | Traffic Signals                            |                       | * Mi. Pt. 0.00 - 0.87                      |
| A.F.E. 605 |            | Bit. Seal Coat (Shoulders)                 |                       | 3573 Gal. M62, Agg. 4000                   |
| C          |            | Grading                                    |                       |  |
| 1960       | 6917-32    | Gravel Base<br>Road Mix Bit. (Base)        | 26' 1 1/2"            |  |
| C          | 6947-11    | Lighting Systems                           |                       | In Hibbing                                 |
| 1961       |            | Grade, Base & Rd. Mix                      |                       | By Maint.                                  |
|            |            | Bit. on Frontage Rds.                      | 24' 1 1/2"            |  |
| M          |            |  |                       |  |
| 1970       | SF         | Shoulder Resurface                         | 6' 1/3 Var.           | MC 250 tack 270 Gal.<br>Agg. 309 Tons      |

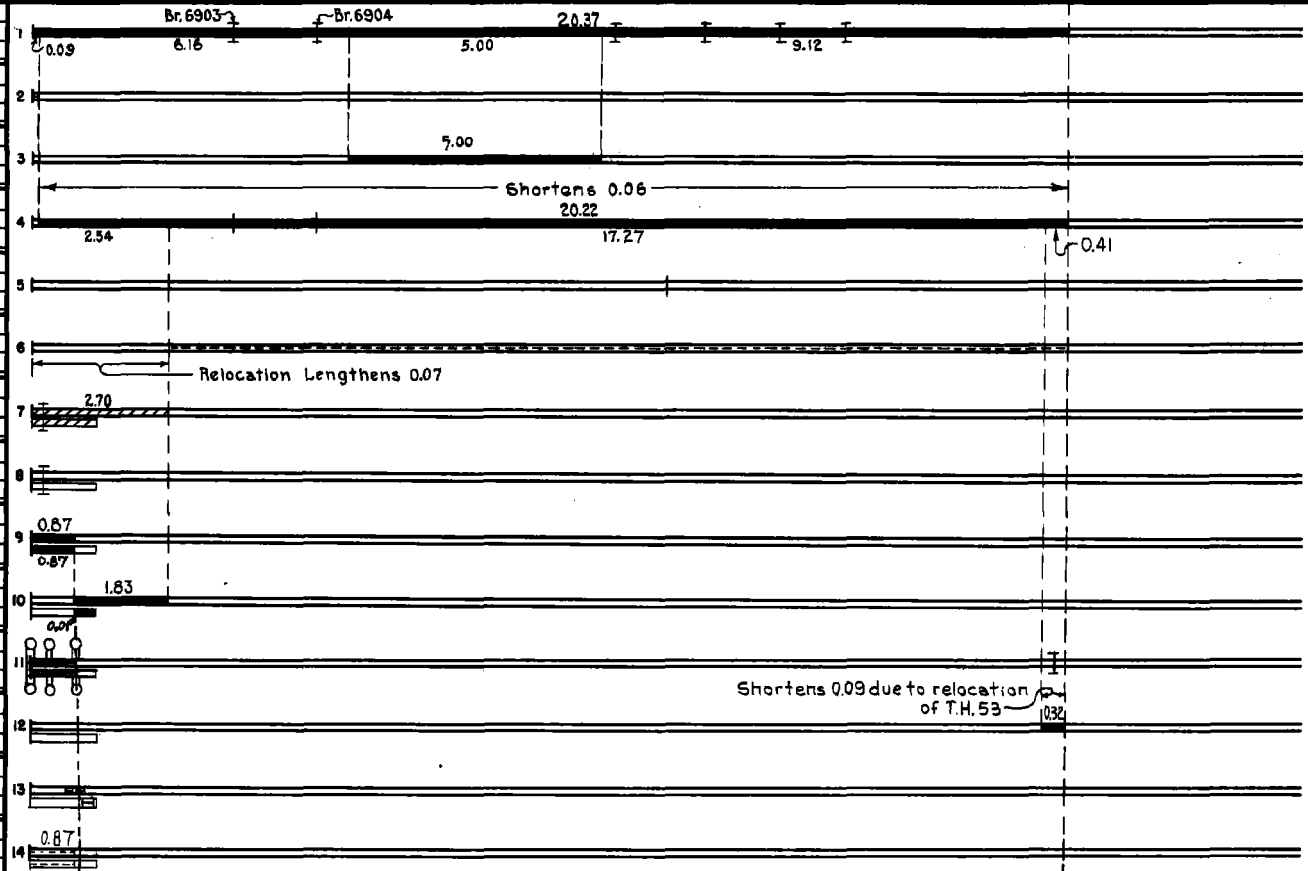

| YEARS FROM TO | TOTAL MILES | UNINCORPORATED |         | INCORPORATED |         | RURAL     |         | URBAN     |         |
|---------------|-------------|----------------|---------|--------------|---------|-----------|---------|-----------|---------|
|               |             | RDWY. MI.      | BR. MI. | RDWY. MI.    | BR. MI. | RDWY. MI. | BR. MI. | RDWY. MI. | BR. MI. |
| 1949 1952     | 20.37       | 18.32          | 0.12    | 1.93         | 0.00    | 18.32     | 0.12    | 1.93      | 0.00    |
| 1953 1955     | 20.31       | 18.31          | 0.10    | 1.90         | 0.00    | 18.31     | 0.10    | 1.90      | 0.00    |
| 1956 1958     | 20.36       | 18.32          | 0.10    | 1.96         | 0.00    | 18.32     | 0.10    | 1.96      | 0.00    |
| 1959 1959     | 20.38       | 18.28          | 0.14    | 1.96         | 0.00    | 18.28     | 0.14    | 1.96      | 0.00    |
| 1960 1971     | 20.29       | 18.19          | 0.14    | 1.96         |         | 18.19     | 0.14    | 1.96      |         |
| 1972 1975     | 20.32       | 18.22          | 0.14    | 1.96         |         | 18.22     | 0.14    | 1.96      |         |
| 1976          | 19.40       | 18.18          | 0.14    | 1.08         |         | 18.18     | 0.14    | 1.08      |         |

REMARKS: Layout is to scale as of 1949 (1) 29' C.D.G. (Br. 6903), 26' C.D.G. (Br. 6904), 51' T.P.G. (Br. 6905), 38' B.S. (Br. 6906), 250' O.H. (Br. 6907) & 714' O.H. (Br. 6909). (2) Apparently the portion westerly of S.A.R. 5 was built by Stuntz township and the portion easterly of S.A.R. 5 by St. Louis Co. Dates unknown. (3) 79% of base is 32' x 6' min. Bit. Stab. Grav. on old conc. or Sand-Grav. sub-base, balance is old 20' conc. which was widened with 6" Bit. Base on 6" Sand-Grav. Sub-base. (4) Contract not final but work substantially complete.





